

RESOLUTION NO. 25186

A RESOLUTION AUTHORIZING THE MAYOR TO EXECUTE A CATHODIC PROTECTION EASEMENT FOR COLONIAL PIPELINE COMPANY RELATIVE TO ENTERPRISE SOUTH INDUSTRIAL PARK PROPERTY JOINTLY OWNED BY THE CITY AND HAMILTON COUNTY, TENNESSEE, IN SUBSTANTIALLY THE FORM ATTACHED HERETO AND MADE A PART HEREOF BY REFERENCE, IN CONSIDERATION OF A TOTAL AMOUNT OF FIVE THOUSAND DOLLARS (\$5,000.00), TO BE DISTRIBUTED EQUALLY BETWEEN THE CITY AND THE COUNTY.

---

BE IT RESOLVED BY THE CITY COUNCIL OF THE CITY OF CHATTANOOGA, TENNESSEE, That the Mayor be and is hereby authorized to execute a Cathodic Protection Easement to allow the installation and maintenance of a cathodic protection facility for the existing Colonial Pipeline located within the Enterprise South Industrial Park property jointly owned by the City and Hamilton County, Tennessee ( the "County"), in substantially the form attached hereto and made a part hereof by reference, in consideration of a total amount of \$5,000.00, to be distributed equally between the City and the County.

ADOPTED: July 24, 2007

/add



ACKNOWLEDGEMENT  
(Corporate)

STATE OF TENNESSEE

COUNTY OF HAMILTON

I, the undersigned authority in and for said County and State, hereby certify that \_\_\_\_\_, whose name as \_\_\_\_\_ is signed to the foregoing instrument and who is known to me, acknowledged before me on this day that, being informed of the contents of the conveyance, (s)he as such officer and with full authority, executed the same voluntarily for and as the act of said corporation.

Given under my hand and official seal this the \_\_\_\_\_ day of \_\_\_\_\_, 2007.

\_\_\_\_\_  
Notary Public

My commission expires \_\_\_\_\_

ACKNOWLEDGEMENT  
(Corporate)

STATE OF TENNESSEE

COUNTY OF HAMILTON


I, the undersigned authority in and for said County and State, hereby certify that \_\_\_\_\_, whose name as \_\_\_\_\_ is signed to the foregoing instrument and who is known to me, acknowledged before me on this day that, being informed of the contents of the conveyance, (s)he as such officer and with full authority, executed the same voluntarily for and as the act of said corporation.

Given under my hand and official seal this the \_\_\_\_\_ day of \_\_\_\_\_, 2007.

\_\_\_\_\_  
Notary Public

My commission expires \_\_\_\_\_

EXHIBIT A

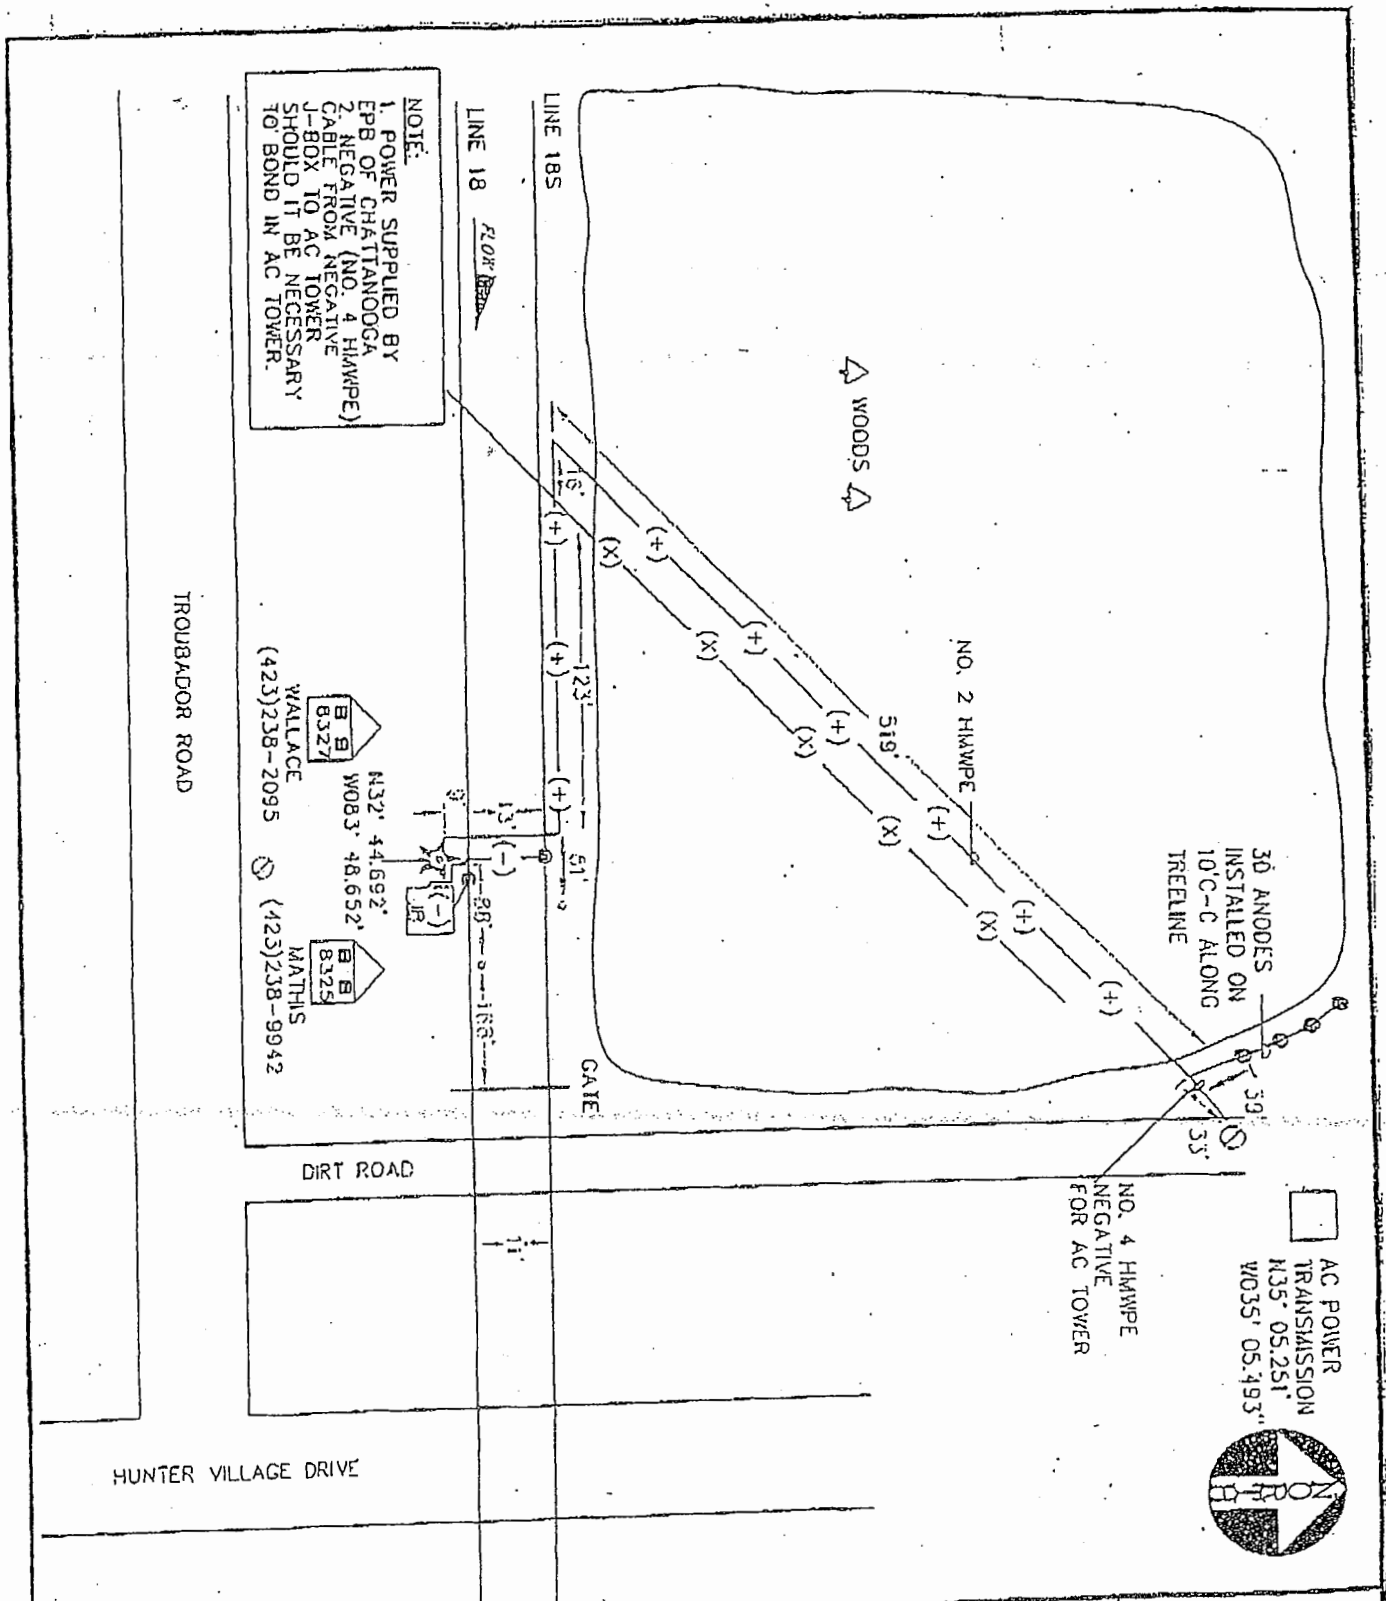

**NOTE:**  
 1. POWER SUPPLIED BY EPB OF CHATTANOOGA  
 2. NEGATIVE (NO. 4 HIWPE) CABLE FROM NEGATIVE J-BOX TO AC TOWER SHOULD IT BE NECESSARY TO BOND IN AC TOWER.

WALLACE  
 N32° 44.692' W083° 48.652' 8327 (423)238-2095  
 MATHIS  
 N32° 44.692' W083° 48.652' 8325 (423)238-9942

AC POWER TRANSMISSION  
 N35° 05.251' W035° 05.493'

NO. 4 HIWPE NEGATIVE FOR AC TOWER

COLONIAL PIPELINE COMPANY ATLANTA, GEORGIA		DESIGN: K.F.
CATHODIC PROTECTION SYSTEM TROUBADOR ROAD AS BUILT		DRAWN: L.C.
HAMILTON COUNTY, TENNESSEE		SCALE: N.T.S.
		DATE: 4-11-07
		SHEET 1 OF 3
REVISION	DATE	
△		
△		
